

# VIDAL/WETTENSTEIN, LLC

Real Estate for Business & Investment

THE MOST AFFORDABLE TRUE OFFICE SPACE IN THIS MARKET




## 444 WESTPORT AVENUE Norwalk, Connecticut

1,930 SF Available

### Comments:

Situated between the Westport town line, (Whole Foods) and Stew Leonards, this office location is convenient to all Westport and Norwalk amenities. Attractive newly fit-up office space offered at below market rates! Full floor opportunity for office or show room potential with great signage and identity.

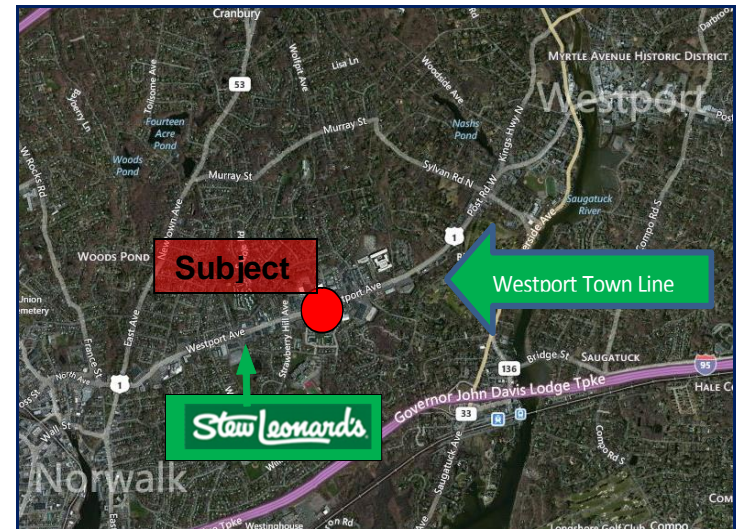

For additional information please contact David Fugitt, SIOR (ext. 5), email [david@vidalwettenstein.com](mailto:david@vidalwettenstein.com)  
Robert Lewis (ext. 7), email [robert@vidalwettenstein.com](mailto:robert@vidalwettenstein.com)

All information from sources deemed reliable and is submitted subject to errors, omissions, change of price, rental, and property sale and withdrawal notice.



Individual Members  
Society of Industrial and Office Realtors

719 Post Road East, Westport, CT 06880  
Phone: (203) 226-7101 Ext 7  
[www.vidalwettenstein.com](http://www.vidalwettenstein.com)

# VIDAL/WETTENSTEIN, LLC

Real Estate for Business & Investment

Make an offer!



**Pylon Sign on US-1**



**Lobby**



**Three-story high lobby**



**Ample Covered Parking**




Individual Members  
Society of Industrial and Office Realtors

719 Post Road East, Westport, CT 06880

Phone: (203) 226-7101

[www.vidalwettenstein.com](http://www.vidalwettenstein.com)

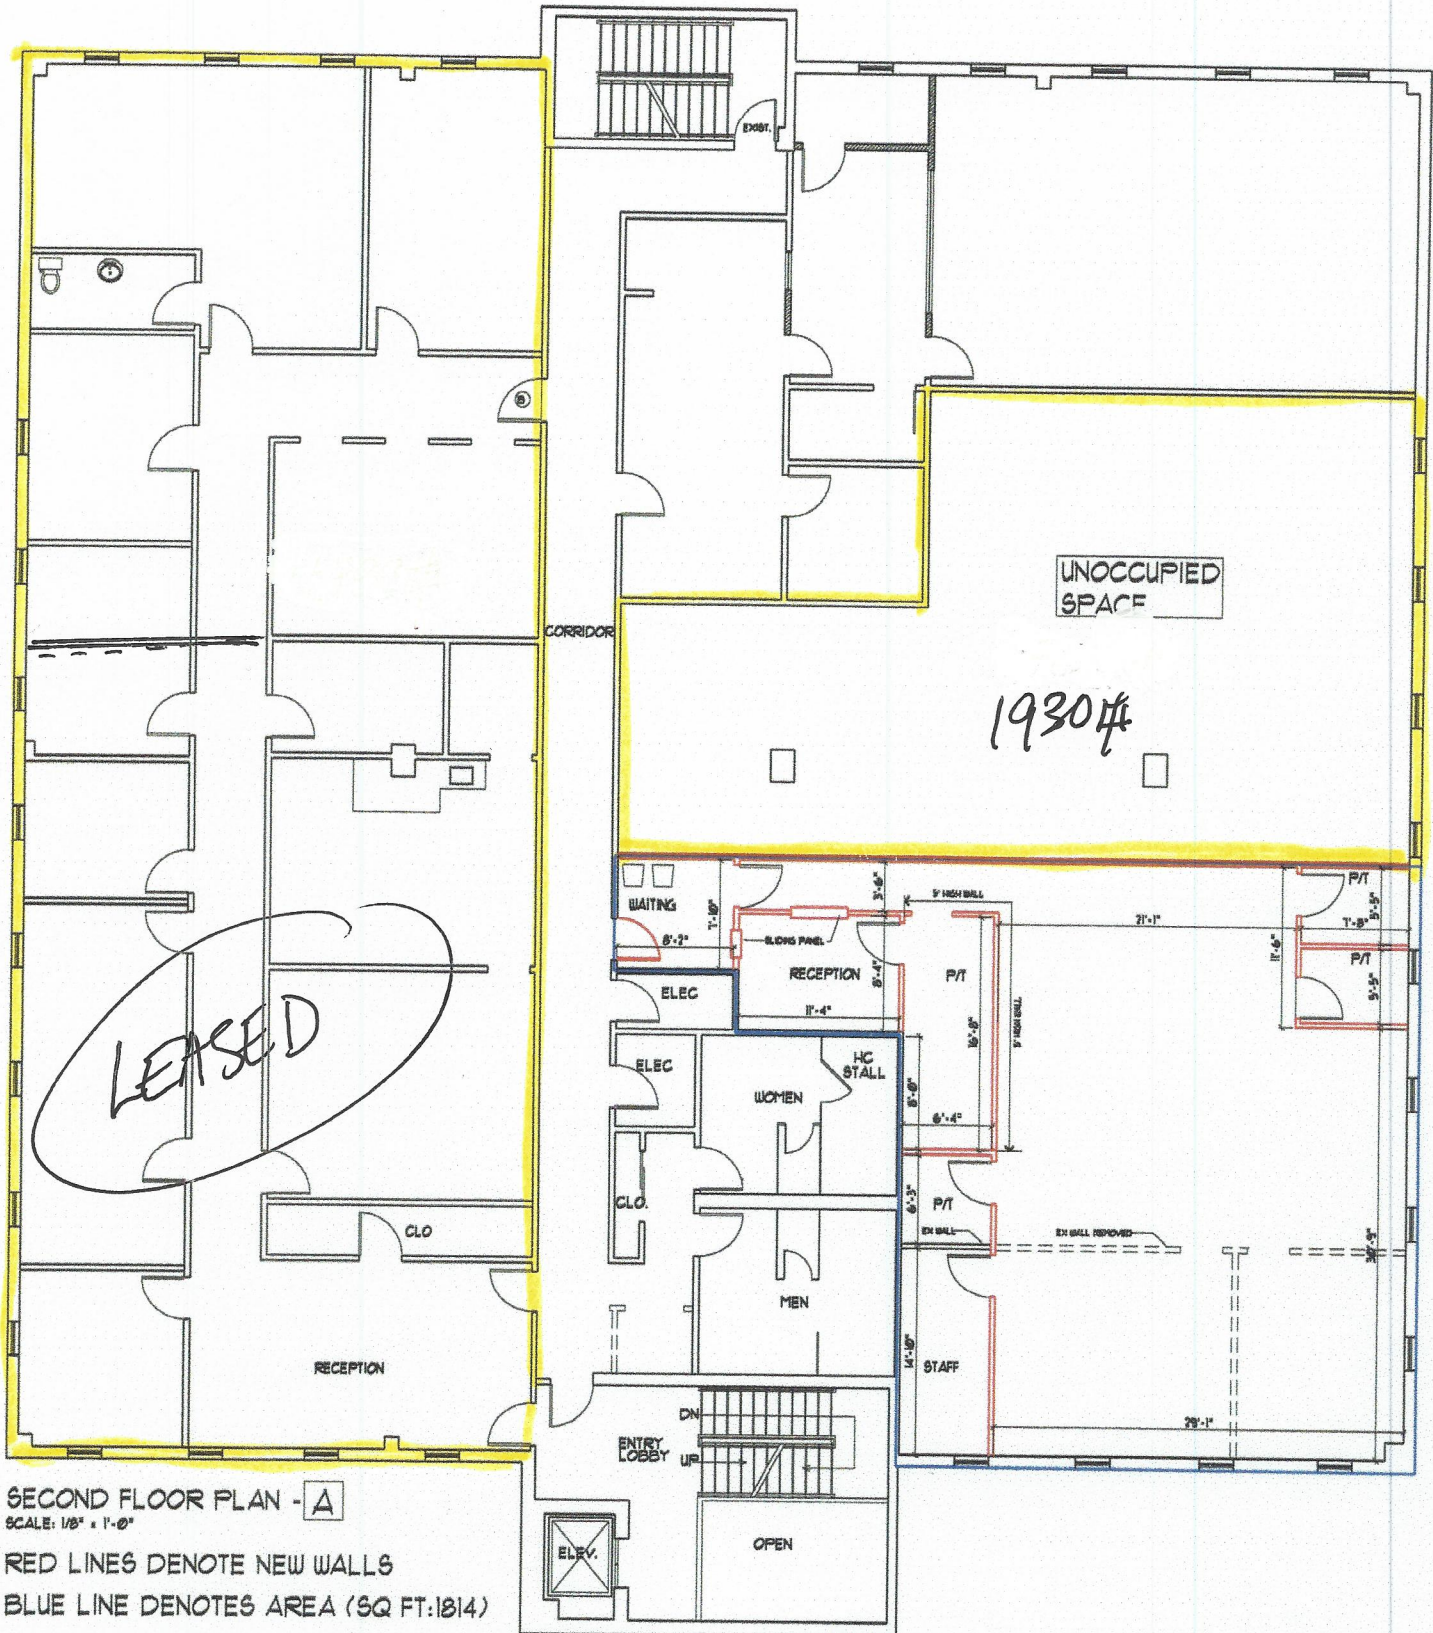

SECOND FLOOR PLAN - A

SCALE: 1/8" = 1'-0"

RED LINES DENOTE NEW WALLS

BLUE LINE DENOTES AREA (SQ FT: 1814)

